

**SCDHEC OFFICE OF OCEAN AND COASTAL RESOURCE MANAGEMENT
PERMIT APPLICATION PUBLIC NOTICE**

February 15, 2008

Permit Number: OCRM-08-820
Permit ID: 62220

The SCDHEC Office of Ocean and Coastal Resource Management has received an application for a permit for the alteration of a critical area. This application was submitted pursuant to the Coastal Zone Management Act (Act 123) of the 1977 South Carolina General Assembly. The application, in brief, is described as follows:

APPLICANT: Debra H Polk
1004 Broad River Drive
Burton SC 29906

LOCATION: On and adjacent to a tributary of the Broad River at 1004 Broad River Drive, Burton, Beaufort County, South Carolina.
TMS#: R100-033-00A-0124-0000.

WORK: The work as proposed and shown on the attached plans consists of making additions to an existing private dock. Specifically, proposed is the addition of a 13'x13' four pile boatlift to the left of an existing 10'x12' fixed pierhead. Also, the applicant proposes to add water and electricity to the structure. The purpose for the dock addition is for the owner's private recreational use.

This public notice is being distributed to all known interested persons and agencies to assist in developing facts on which a decision by OCRM can be based. Comments concerning the proposed work should be submitted in writing, setting forth sufficient detail to furnish a clear understanding of the reasons for support or opposition.

The decision to issue or deny a permit will be based on the individual merits of the application, the policies specified in the South Carolina Coastal Zone Management Act, and the considerations outlined in the State of South Carolina Coastal Zone Management Program. Interested parties who wish to be notified of final permit action must notify OCRM in writing of this request.

To assure review by OCRM, comments regarding this application must be received by OCRM on or before March 1, 2008. For further information please contact the project manager for this activity, Geordie Madlinger at 843-846-9400.

PLEASE REPLY TO:

SCDHEC OFFICE OF OCEAN AND COASTAL RESOURCE MANAGEMENT
104 Parker Drive
Beaufort, South Carolina 29906


Please refer to P/N# OCRM-08-820



G. J. Madlinger, III, Project Manager

DOCK PERMIT
PREPARED FOR
DEBRA & ROBERT POLK

ENDS OF WALK
A N 197581.67
E 2080766.13
B N 197531.02
E 2080723.38

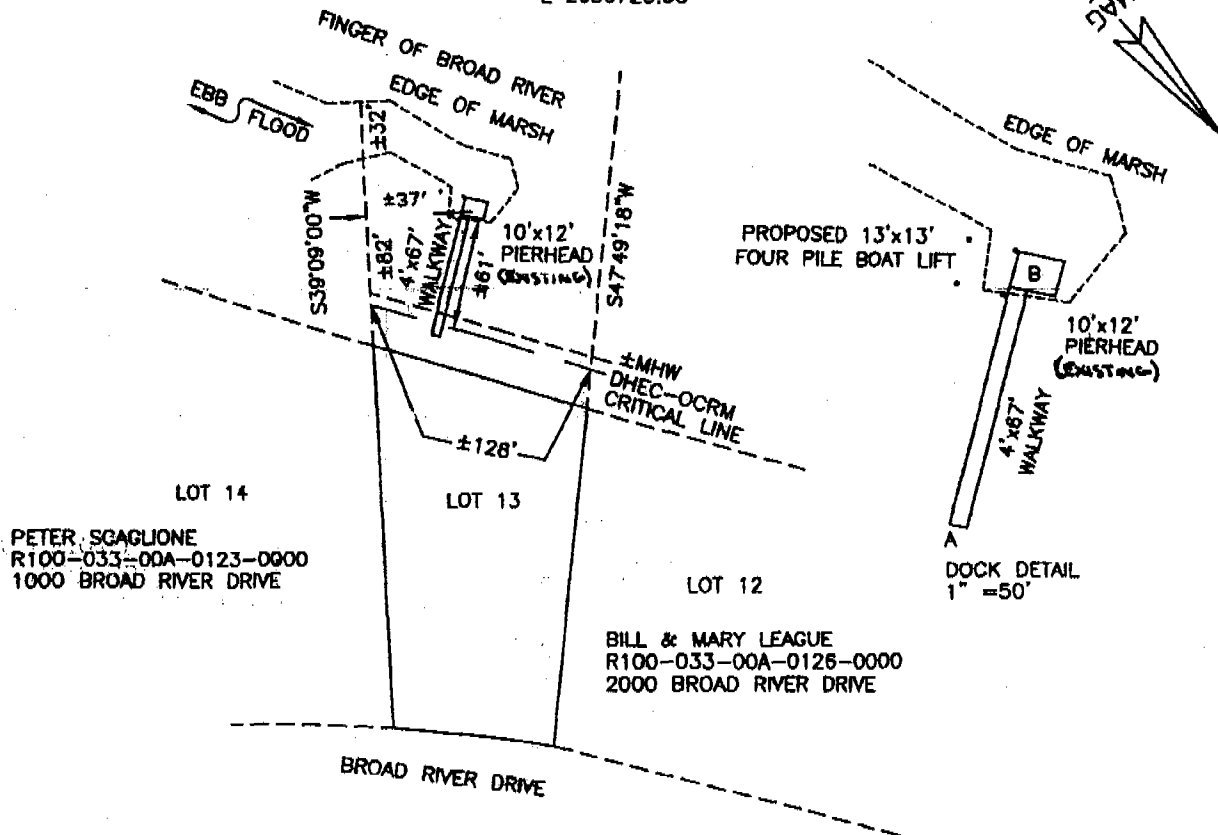

I HEREBY CERTIFY TO THE DIMENSIONS SHOWN
ON THIS SKETCH THAT PERTAIN TO CRITICAL LINE
AND MARSH LINE.

PIN: R100-033-00A-0124-0000

0 50' 100' 200' 300'

SCALE 1" = 100'


DECEMBER 21, 2007
P10972DS/JJ

OCRM-08-820

David S. Youmans
DAVID S. YOUMANS RLS 9765
BEAUFORT SURVEYING, INC.
1613 PARIS AVENUE
PORT ROYAL, S.C. 29935
PHONE (843) 524-3261

<p>APPLICANT: DEBRA & ROBERT POLK ACTIVITY: PROPOSED BOAT LIFT</p>	<p>LOCATION: 1004 BROAD RIVER DRIVE SHELL POINT COUNTY: BEAUFORT DATE: 12/21/07</p>	<p>ADJACENT PROPERTY OWNERS PETER SCAGLIONE BILL & MARY LEAGUE</p>
--	---	--

DOCK AS-BUILT
PREPARED FOR
DEBRA & ROBERT POLK

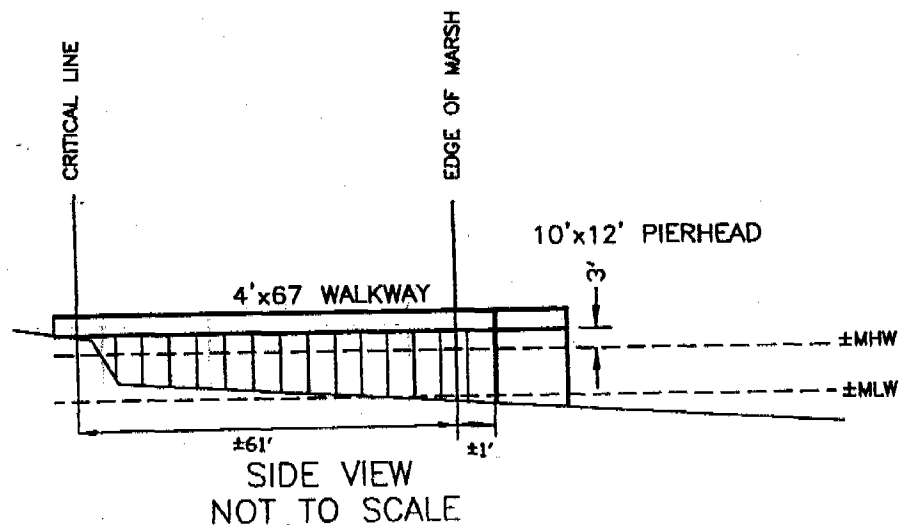

I HEREBY CERTIFY TO THE DIMENSIONS SHOWN
ON THIS SKETCH THAT PERTAIN TO CRITICAL LINE
AND MARSH LINE.

BILL & MARY LEAGUE
R100-033-00A-0126-0000
2000 BROAD RIVER DRIVE

PETER SCAGLIONE
R100-033-00A-0123-0000
1000 BROAD RIVER DRIVE

PIN: R100-033-00A-0124-0000

P10972DS/JJ

CEM-08-B20

David S. Youmans
DAVID S. YOUNG RLS 9765
BEAUFORT SURVEYING, INC.
1613 PARIS AVENUE
PORT ROYAL, S.C. 29935
PHONE (843) 524-3261

APPLICANT:

DEBRA & ROBERT POLK

ACTIVITY: DOCK AS-BUILT

LOCATION: 1004 BROAD RIVER DRIVE
SHELL POINT


COUNTY: BEAUFORT

DATE: 12/21/07

ADJACENT PROPERTY OWNERS

PETER SCAGLIONE

BILL & MARY LEAGUE

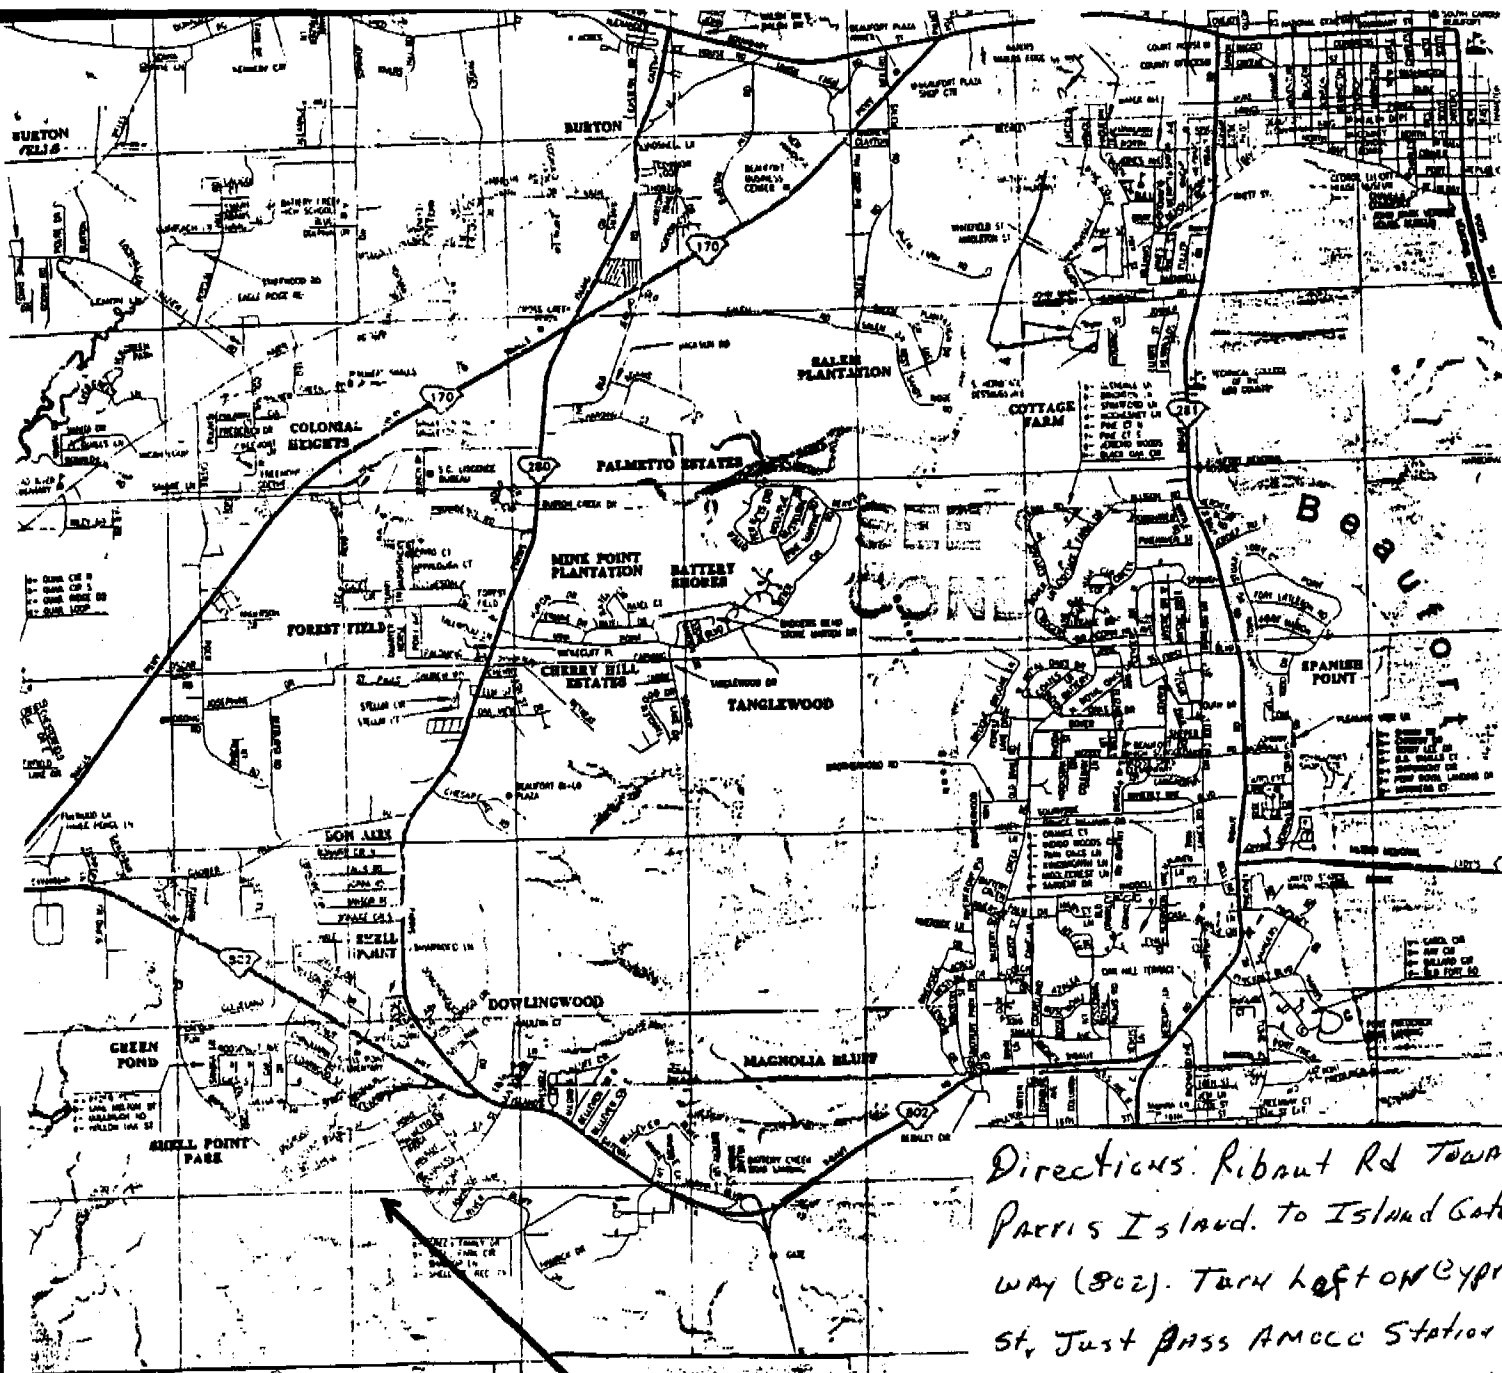

Directions: Ribaut Rd TOWARD
Parris Island. to Island Gate
way (902). Turn Left on Cypress
St. Just pass AMCC Station
go to Stop Sign and Turn Left
on Broad River Dr. Site 1004
will be 4th House on Right.

L13	Willowood Ln	N67
M13	Willowood Ln	K15
O4	Willowood Ln	N67
N4	Willowood Ln	L70
O4	Village Rd	Q11
N4	Village Rd	345
L17	Village St	K17
H12	Village St	345
O12	Village St	345
D16	Village St	345
N4	Village St	345
L69	Village St	345
L69	Village St	345
L19	Village St	345
X21	Village St	345
L17	Village St	345
K12	Village St	345
L17	Village St	345

APPLICANT: Robert & Debra Polk
ACTIVITY: Private Crabbing
DOCK

1/N # OCRM-08-820

LOCATION: 1004 Broad River Dr.
Shell Point Subd.

COUNTY: Beaufort

DATE: 2-11-08

ADJACENT PROPERTY OWNERS:

1-Pete Scaglione

2-William League